



BASEMENT LEVEL PLAN

SCALE 1/8" = 1'-0"

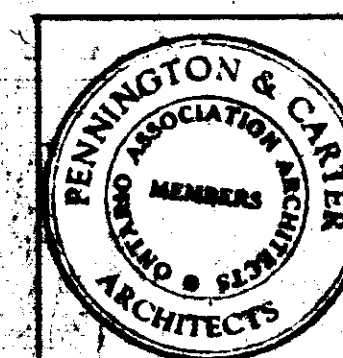


LIBRARY BUILDING		JOB NO.
FOR ASSUMPTION UNIVERSITY - WILSON		1152
PENNINGTON & CATER ARCHITECTS		SHEET NO.
MOBILE, ALABAMA		2
DATE		11/15/52

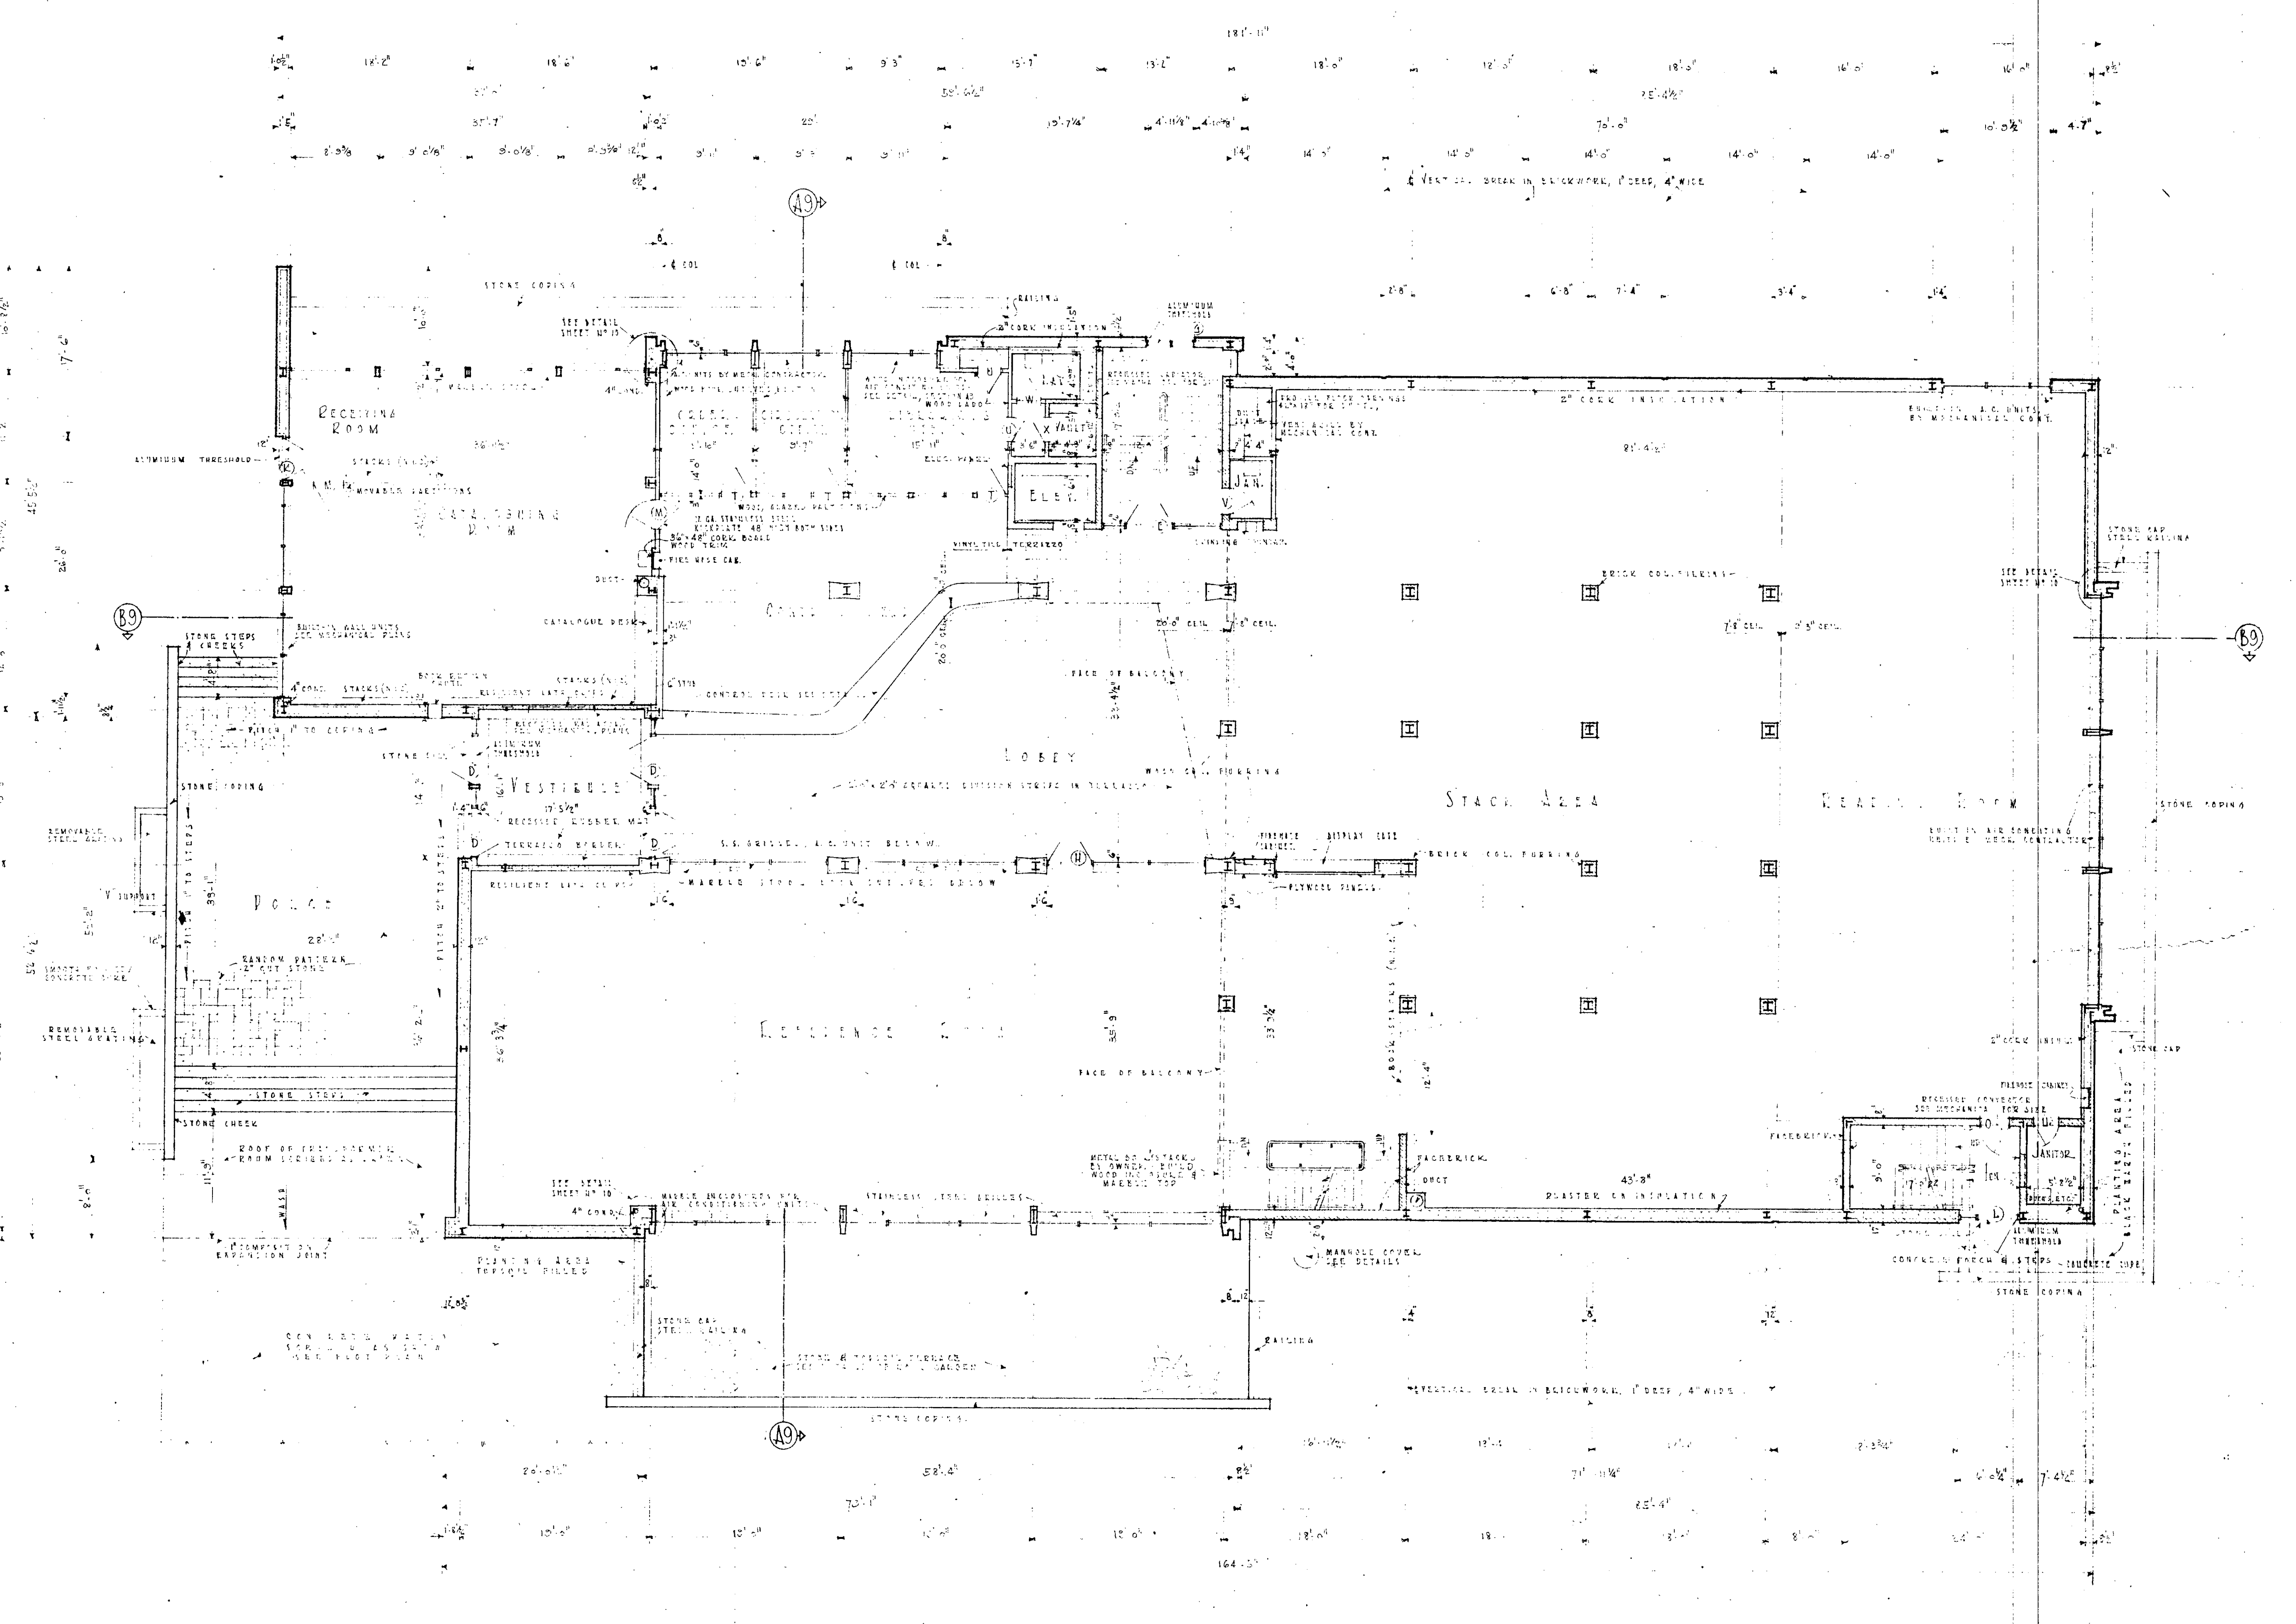


FIRST FLOOR LEVEL
 SCALE - 1/8" = 1'-0"

	LIBRARY BUILDING		101 1/2'
	FOR		1152'
	ASSUMPTION UNIVERSITY - WINNIPEG		SHEET NO.
	PENNINGTON & CARTER ARCHITECTS		DATE
WINNIPEG, MANITOBA		WINNIPEG, MANITOBA	MAY 1957

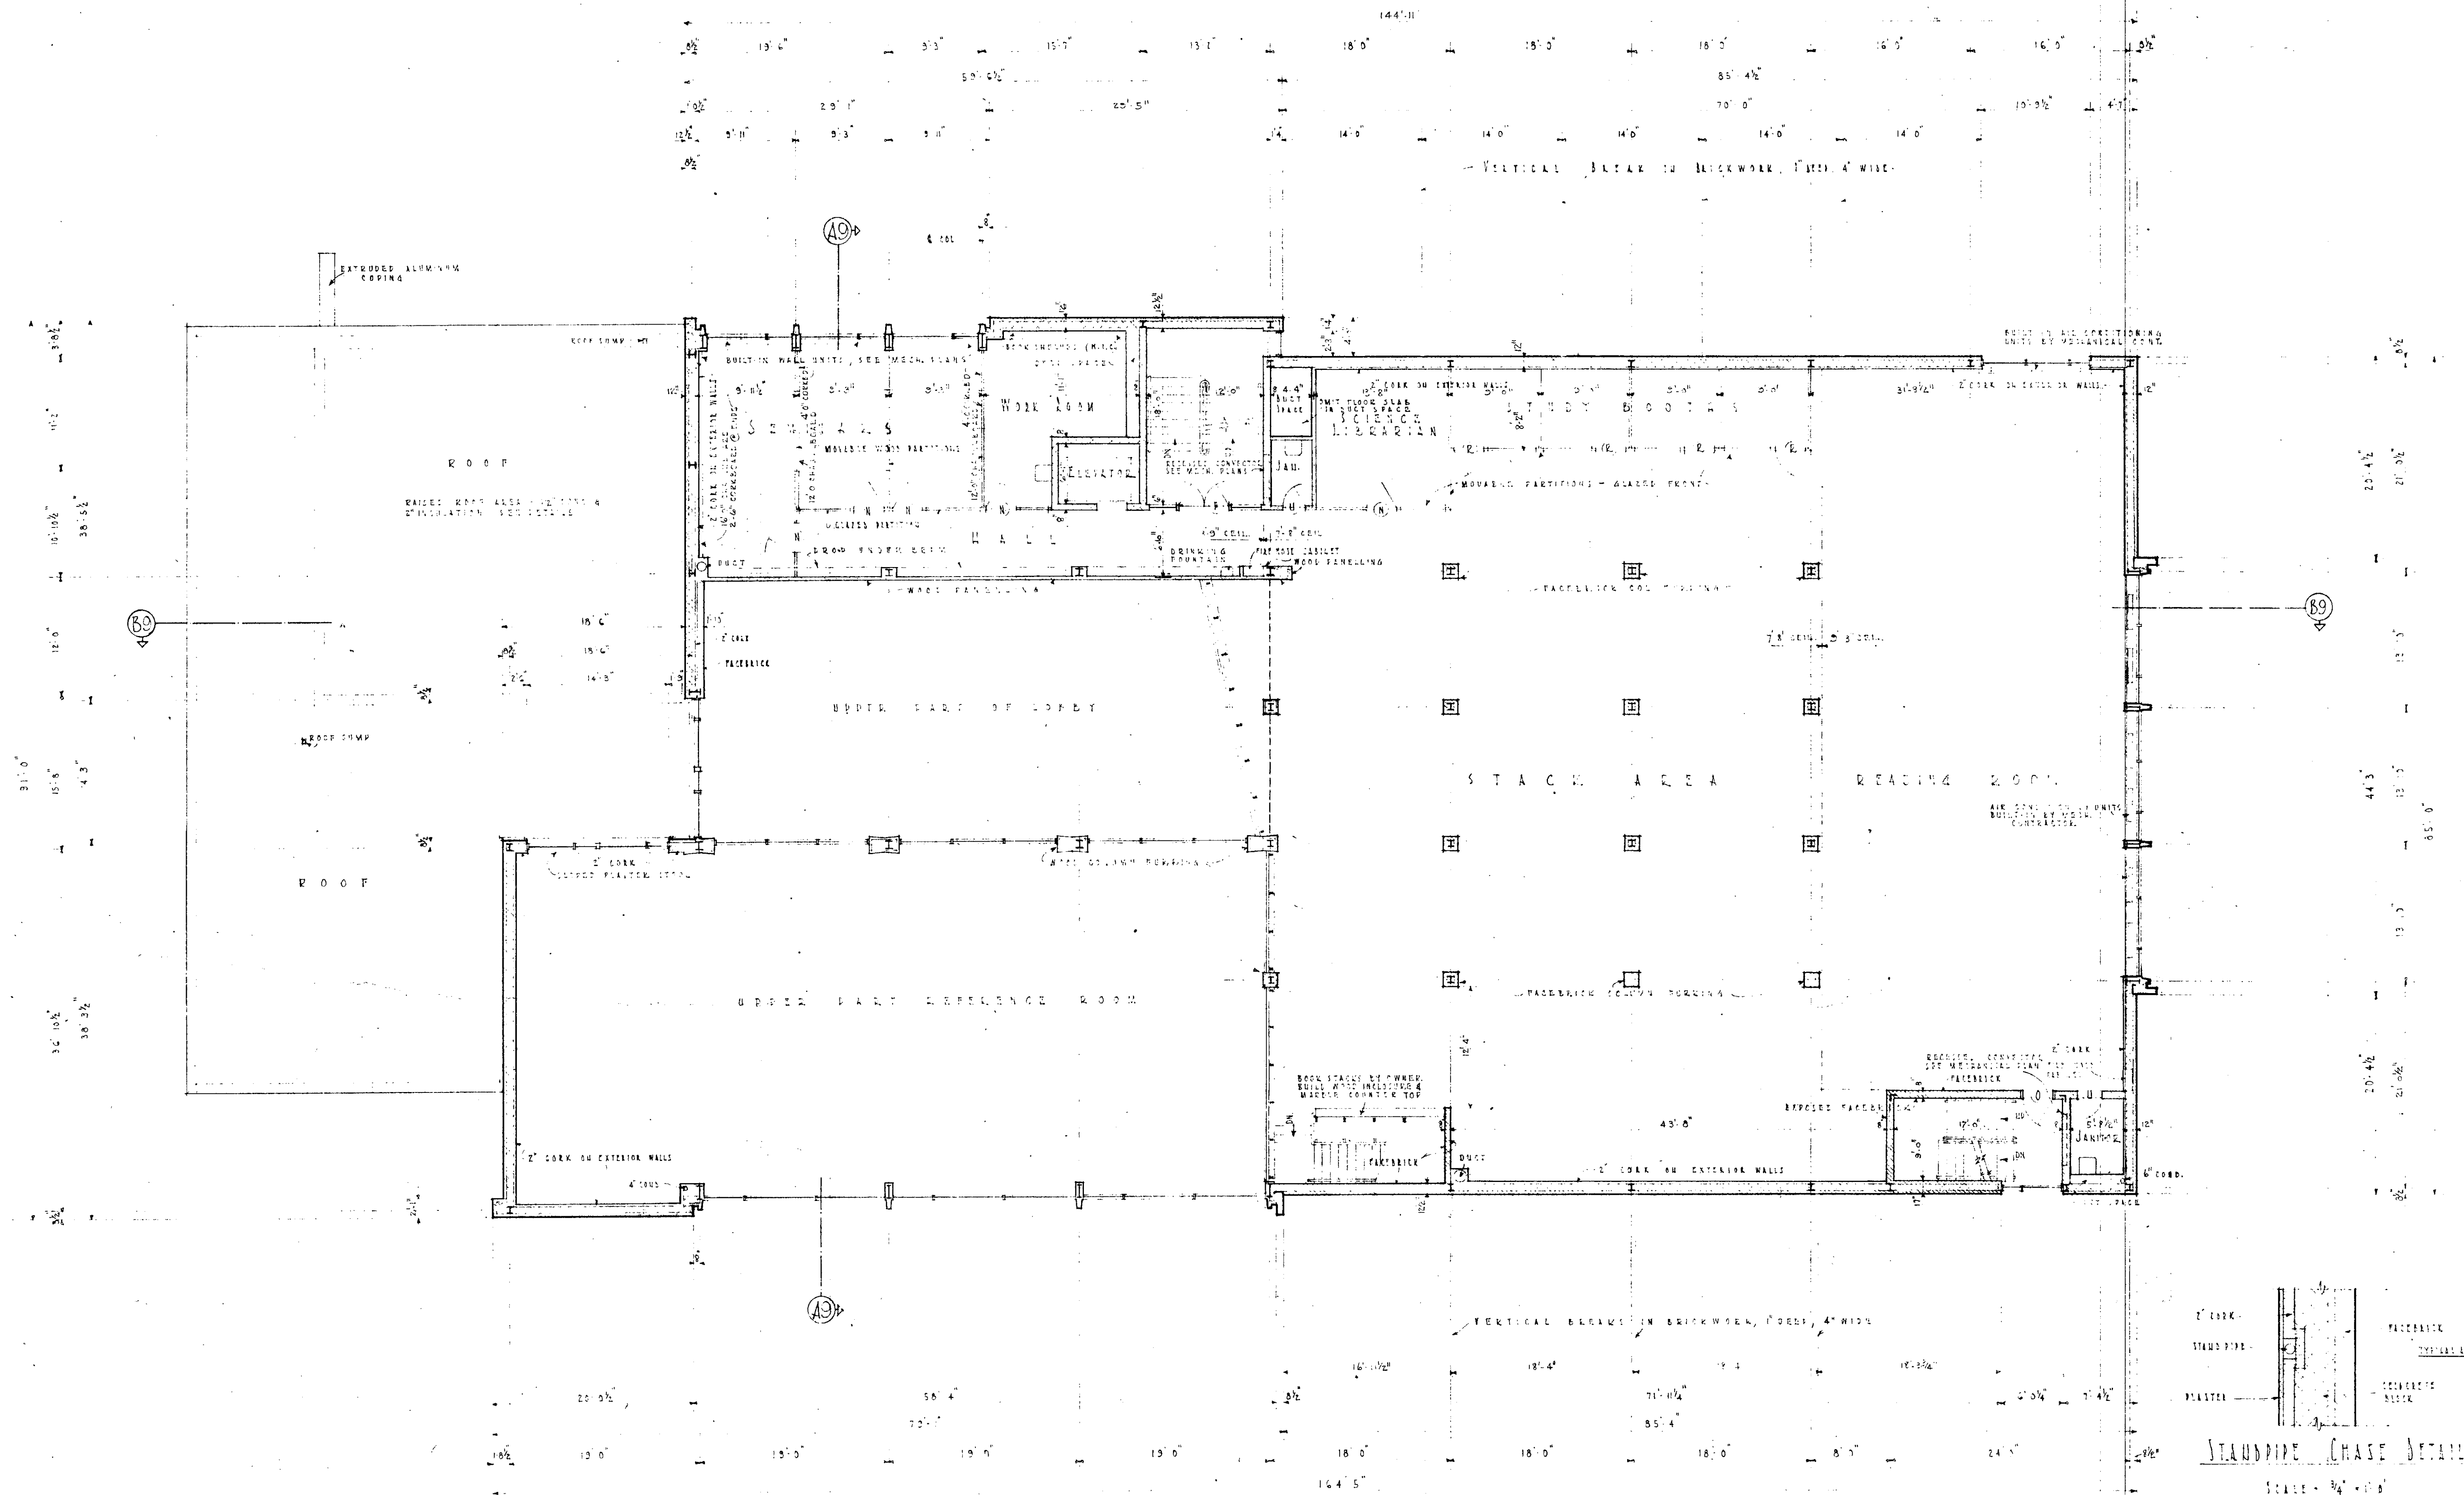


SECOND (MEZZANINE) LEVEL PLAN

SCALE - 3/8" = 1'-0"

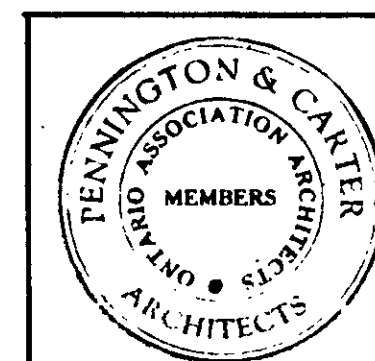

LIBRARY BUILDING
FOR
ASSUMPTION UNIVERSITY OF WINDSOR
PENNINGTON & CARTER, ARCHITECTS
WINDSOR, ONTARIO


JOB NO.
1152
SHEET NO.
4
DATE
MAY 18, 1957

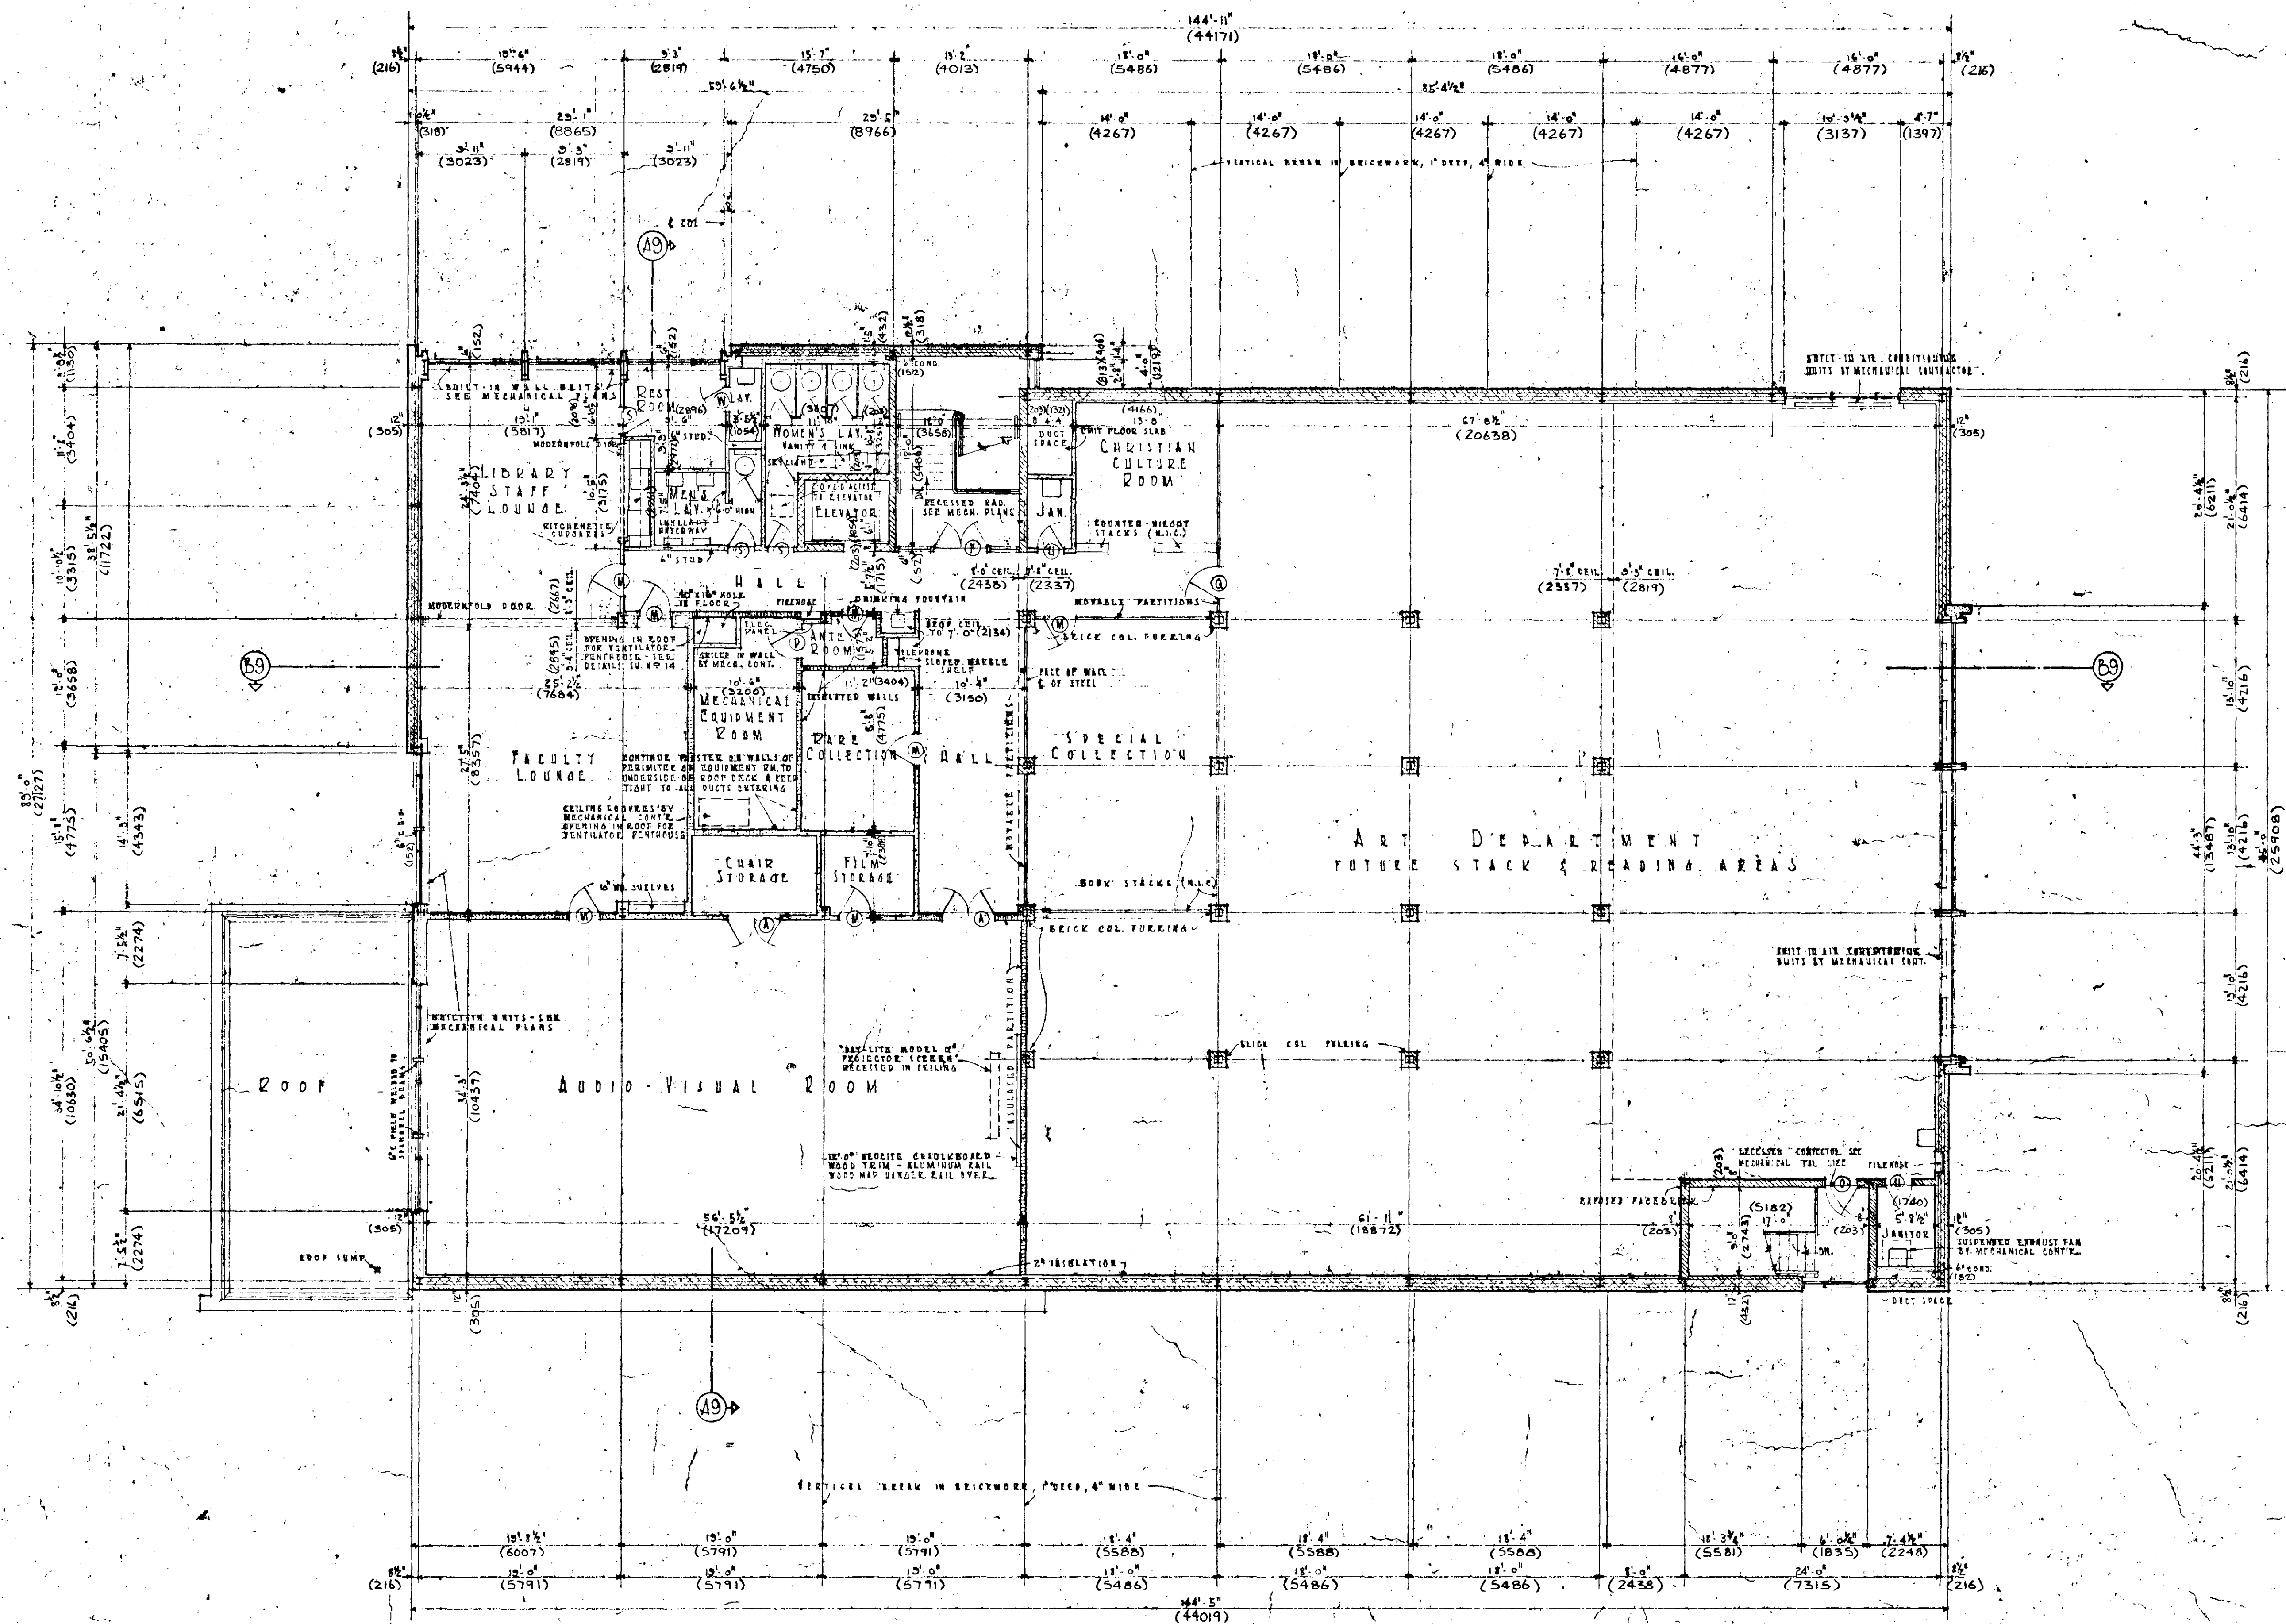


THIRD LEVEL PLAN

SCALE: 1/8" = 1'-0"

"METRIC" MEASUREMENTS SHOWN IN PARENTHESES ARE IN MILLIMETRES AND ARE EQUIVALENT TO IMPERIAL MEASUREMENTS SHOWN

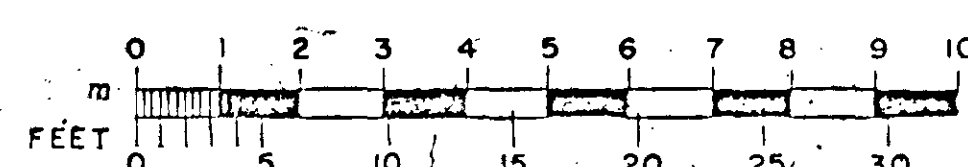


AS BUILT - METRIC CONVERSIONS MAR. 31, 93 L.R.K.

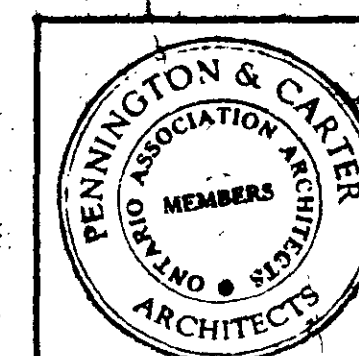

LIBRARY BUILDING
FOR
ASSUMPTION UNIVERSITY / WINSTON
PENNINGTON & CARTER, ARCHITECTS
MORRIS BUILDING WINSTON, ONTARIO


JOB NO. 1152
SHEET NO. 5
DATE MAY 18/59

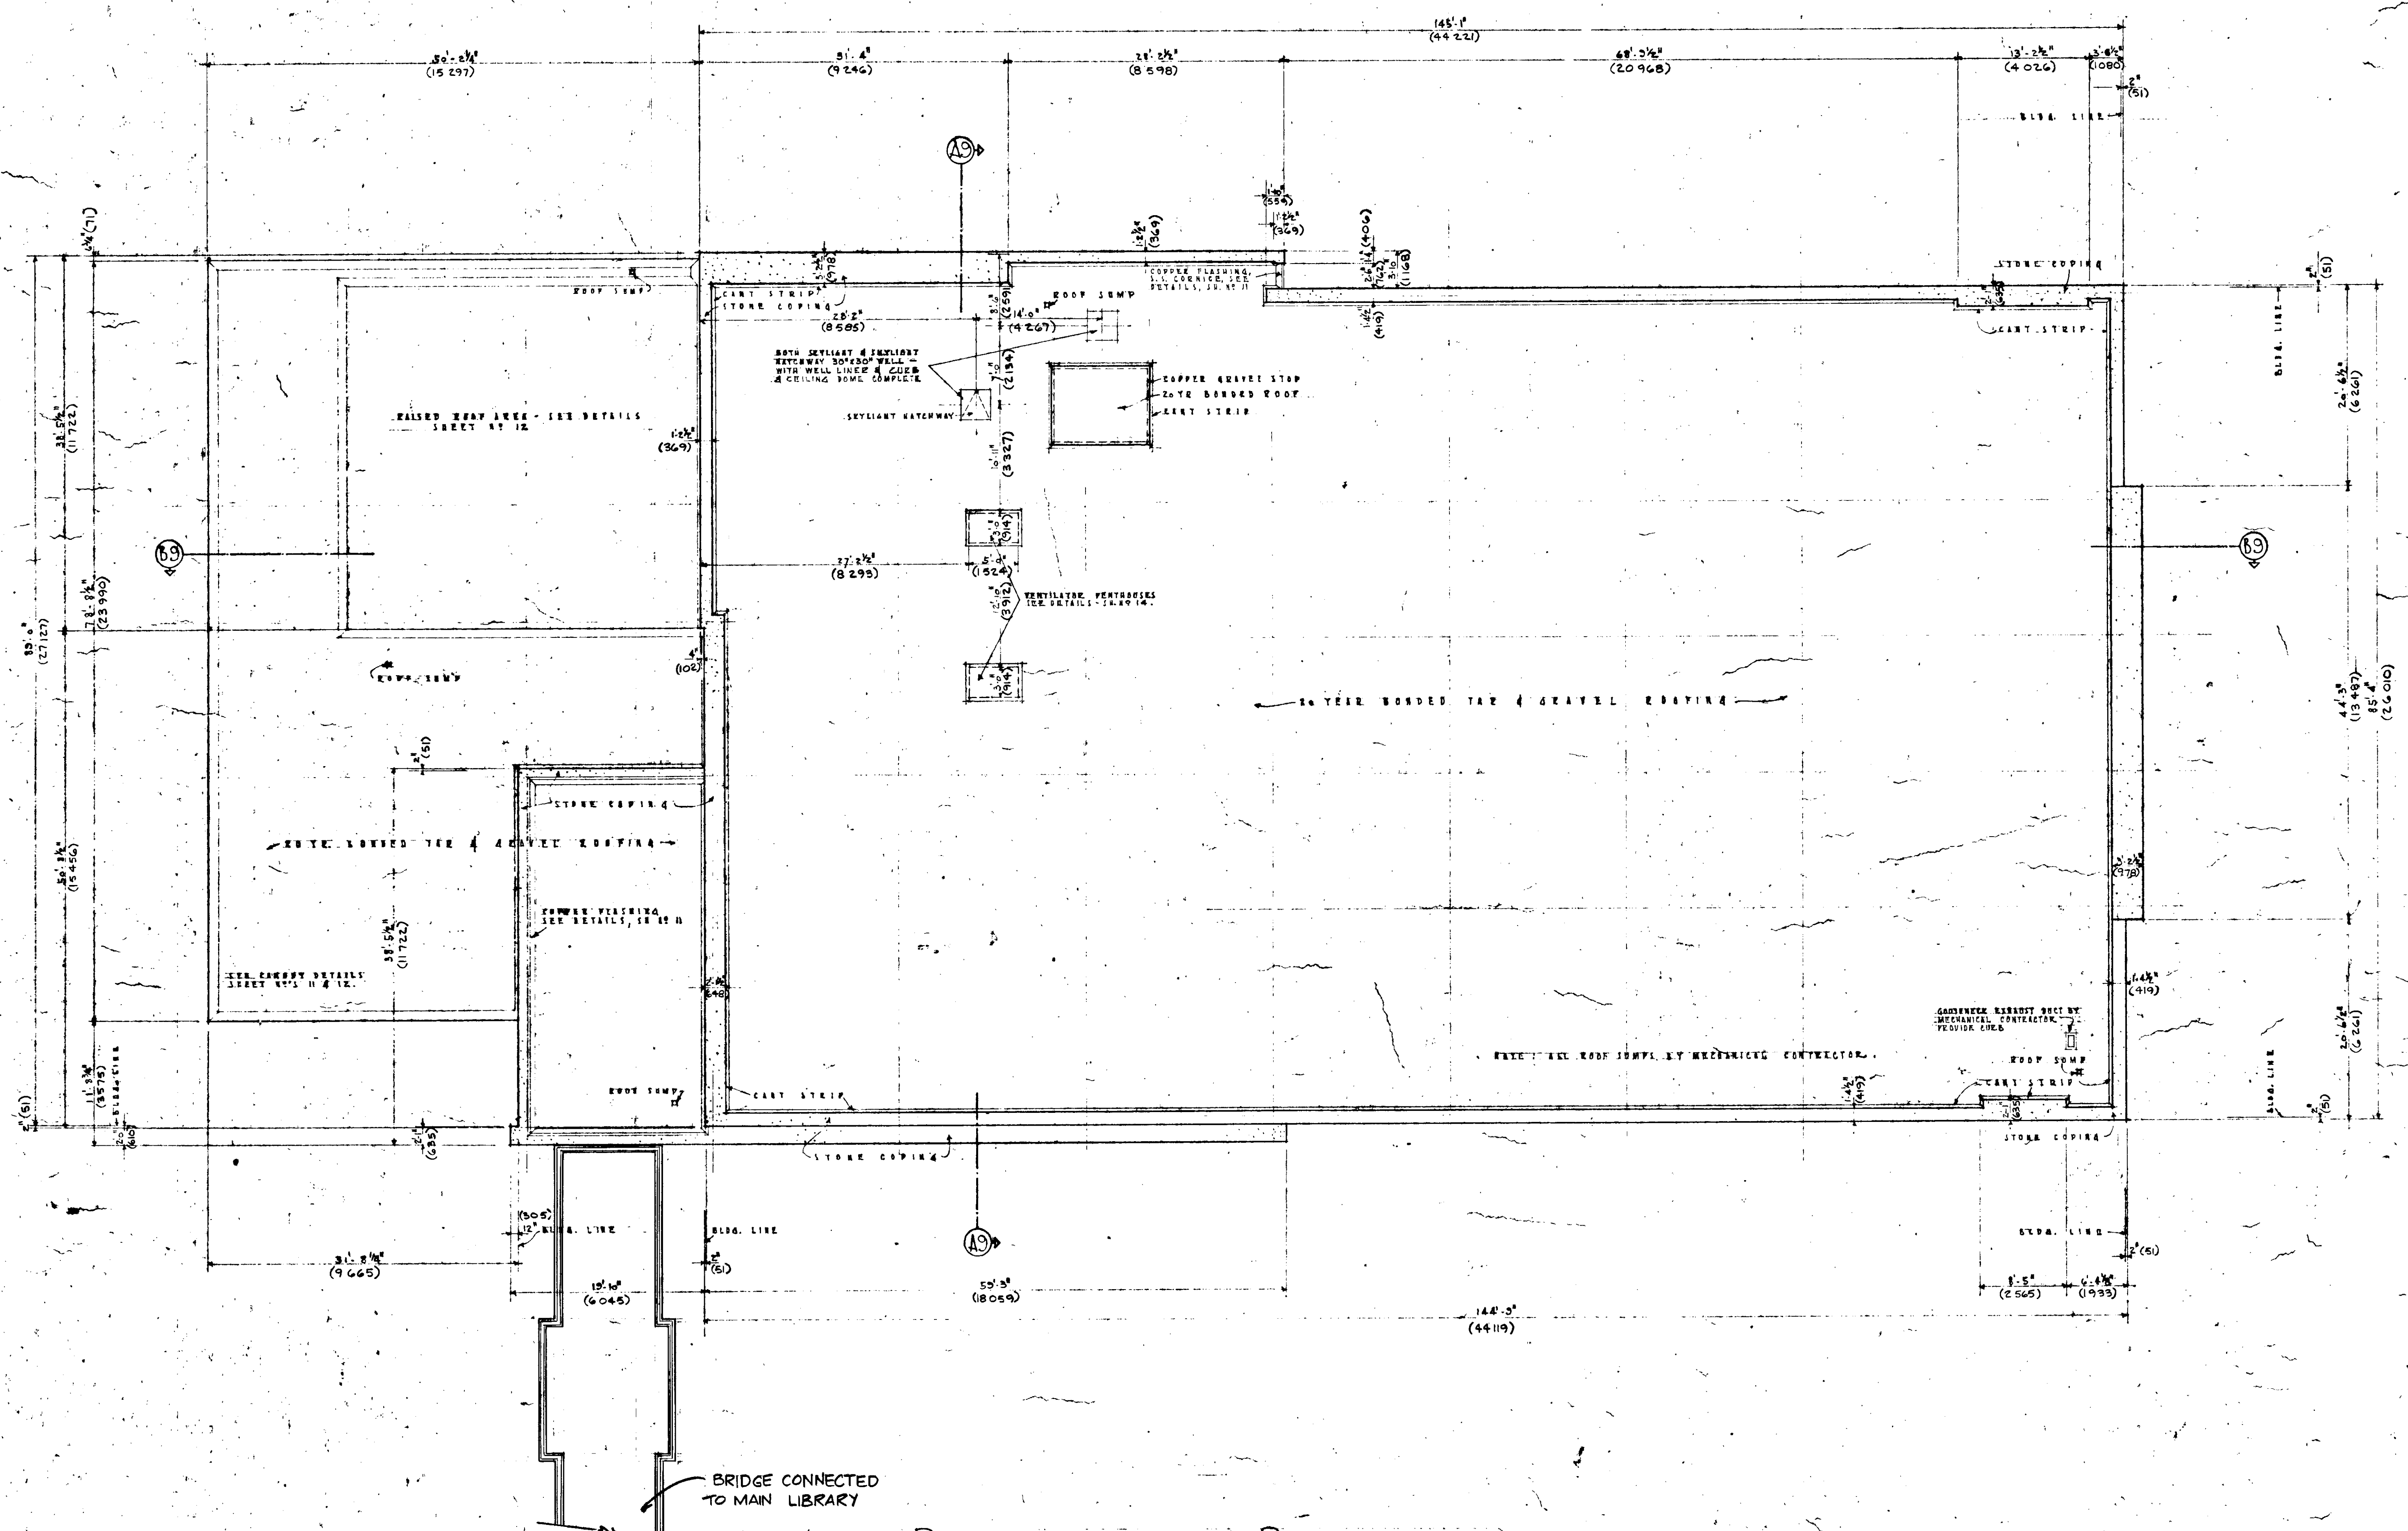


ROOF PLAN

SCALE 1/8" = 1'-0"

"METRIC" MEASUREMENTS SHOWN IN PARENTHESIS ARE IN MILLIMETRES AND ARE EQUIVALENT TO IMPERIAL MEASUREMENTS SHOWN

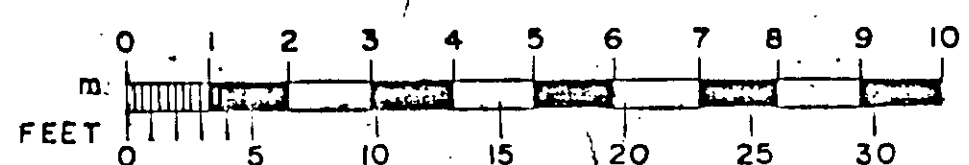

DATE	REVISIONS
MARCH 3, 1953	AS BUILT & METRIC CONVERSIONS

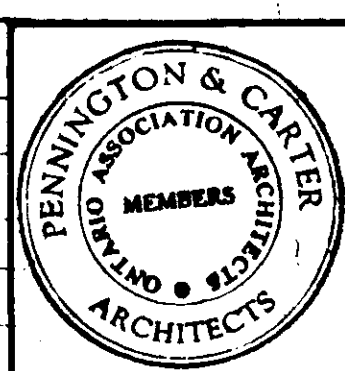

LIBRARY BUILDING

FOR

ASSUMPTION UNIVERSITY OF WINSTON


PENNINGTON & CARTER ARCHITECTS

WILMINGTON BUILDING

JOB NO. 1152


SHEET NO. 6

DATE MAY 18, 1957

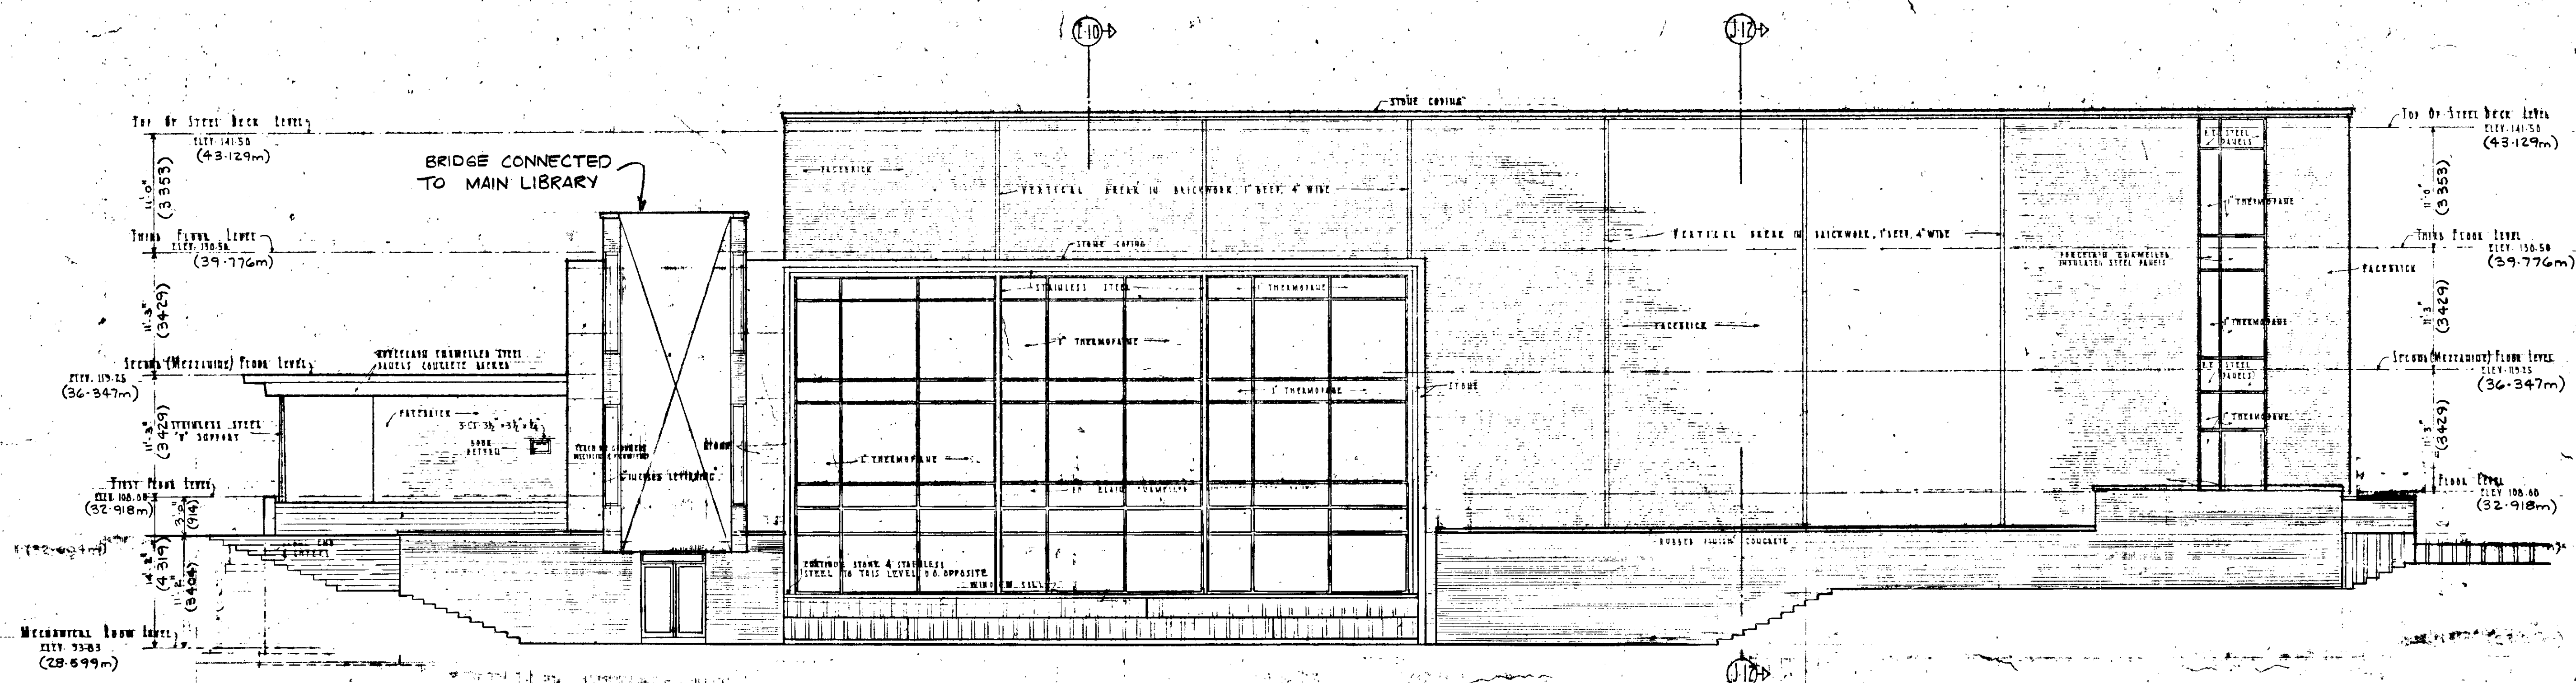

EAST ELEVATION


SCALE: 1/8" = 1'-0"

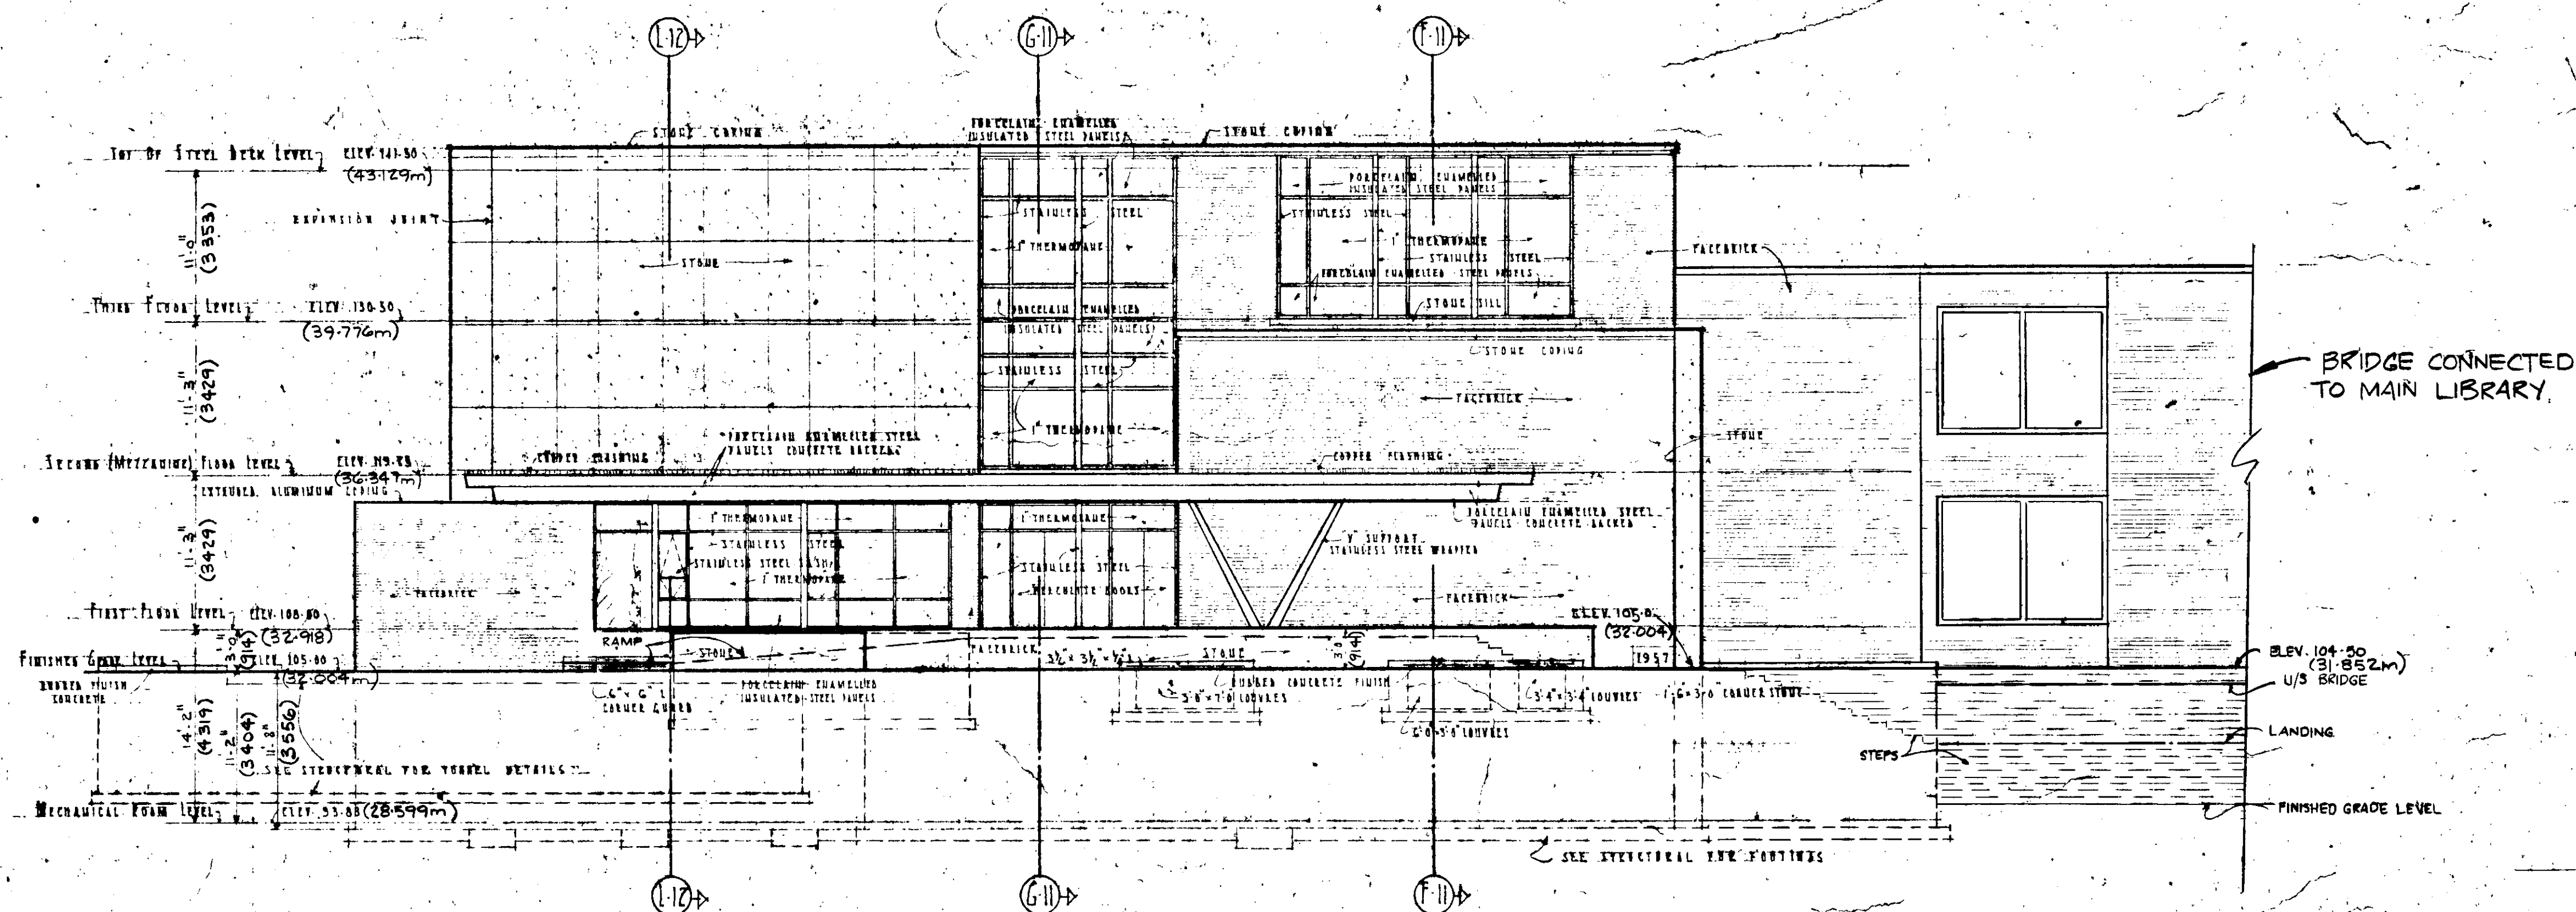


SOUTH ELEVATION

SCALE: 1/8" = 1'-0"

"METRIC" MEASUREMENTS SHOWN IN PARENTHESIS ARE IN MILLIMETRES AND ARE EQUIVALENT TO IMPERIAL MEASUREMENTS SHOWN


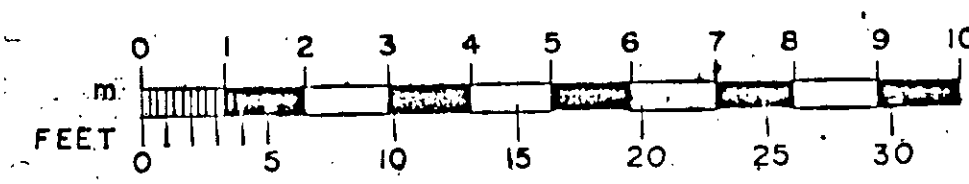


DATE	REVISIONS
MARCH 1972	AS BUILT & METRIC CONVERSIONS

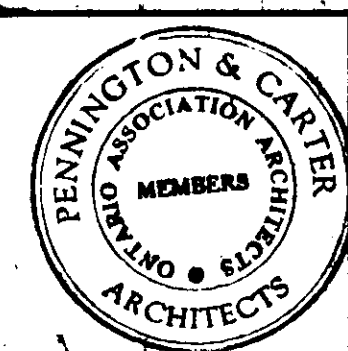


LIBRARY BUILDING
FOR
ASSUMPTION UNIVERSITY & WINDSOR
PENNINGTON & CARTER, ARCHITECTS
MORRIS BUILDING WINDSOR, ONTARIO


JOB NO.
1152
SHEET NO.
7
DATE
MAY 18, 1972

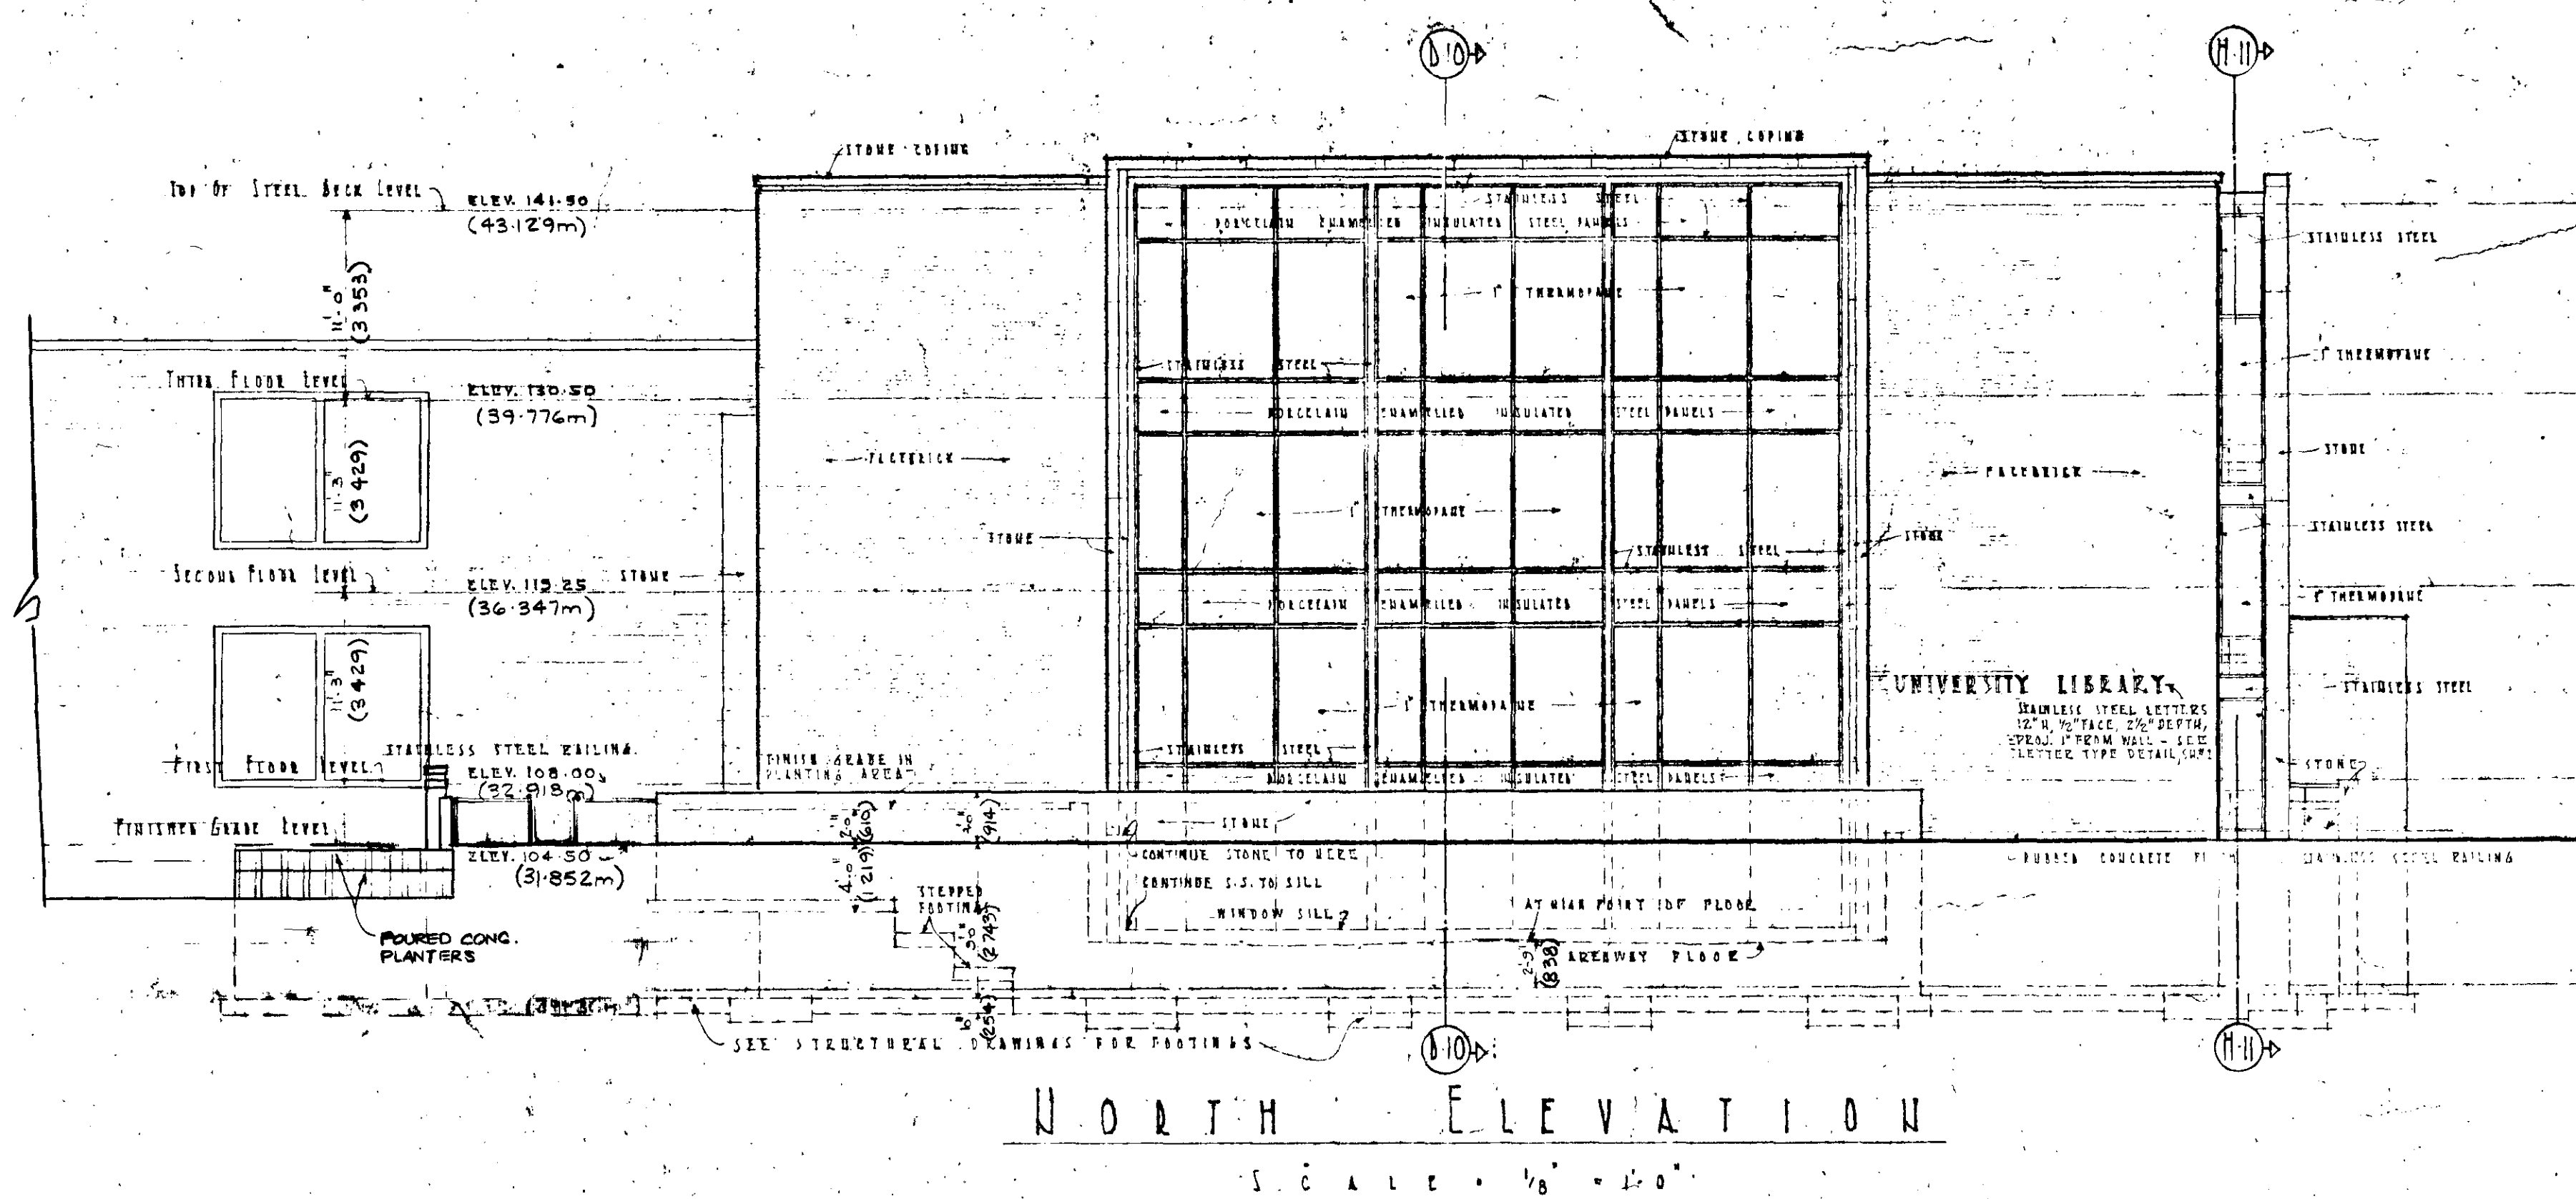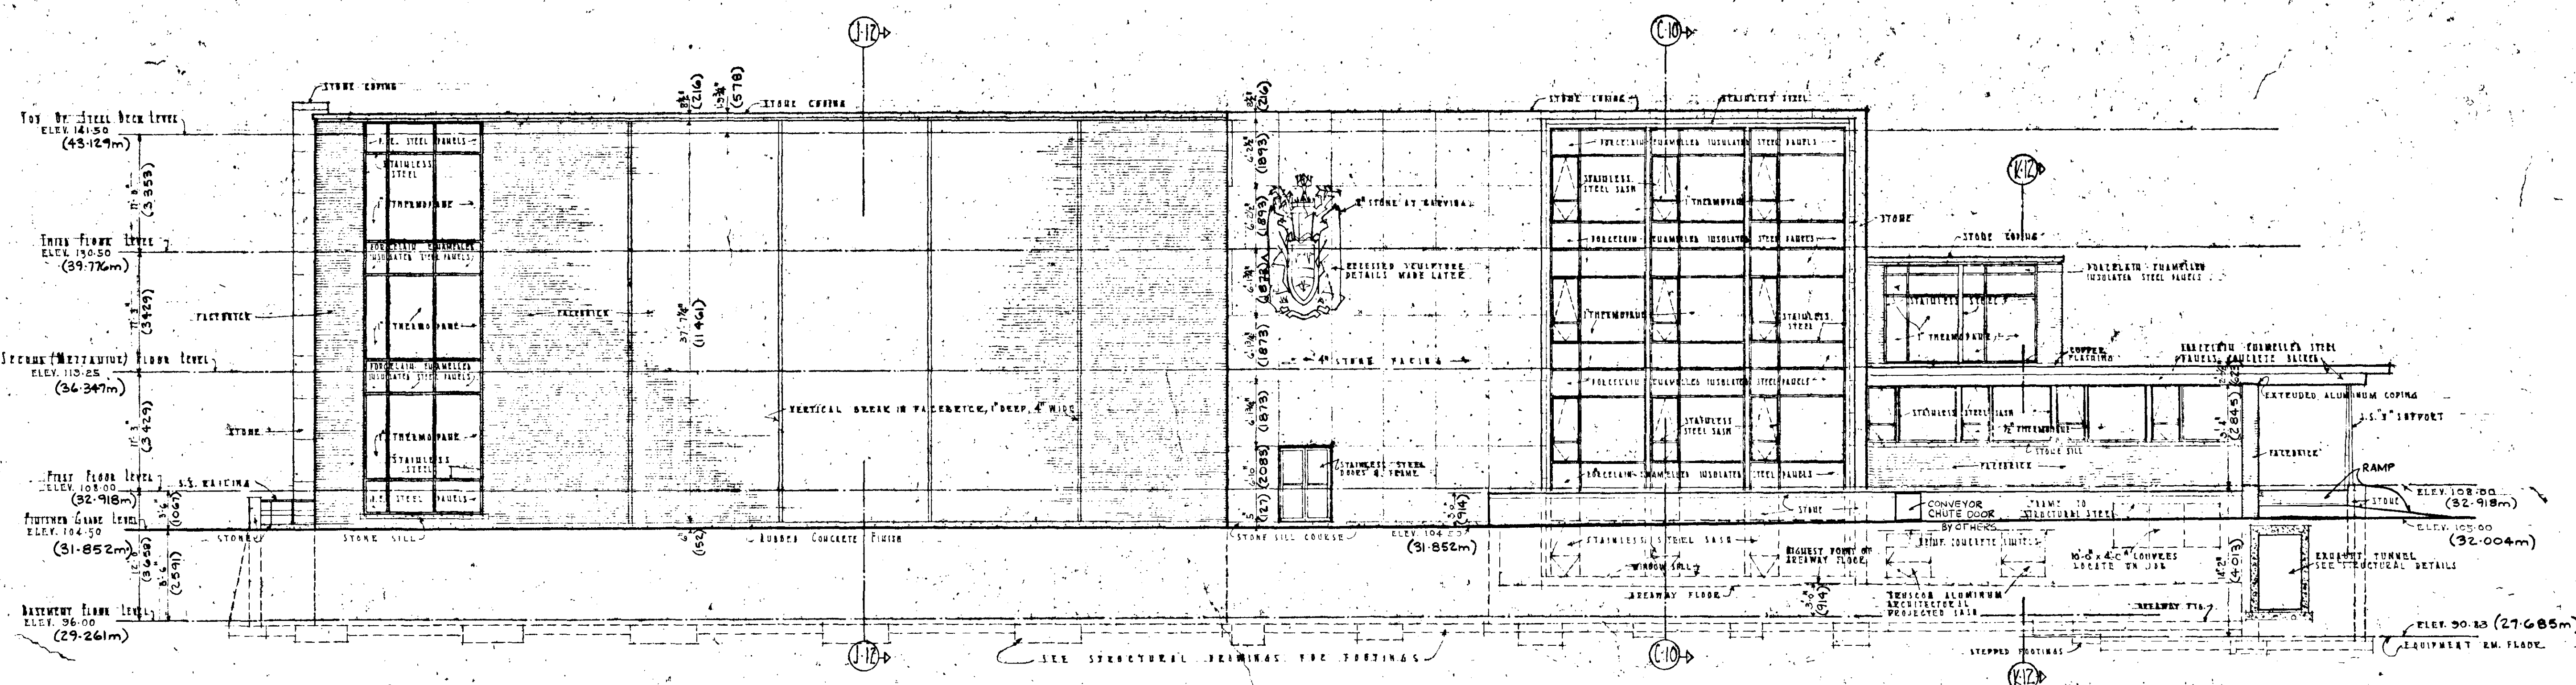

"METRIC" MEASUREMENTS SHOWN IN PARENTHESIS
ARE IN MILLIMETRES AND ARE EQUIVALENT
TO IMPERIAL MEASUREMENTS SHOWN

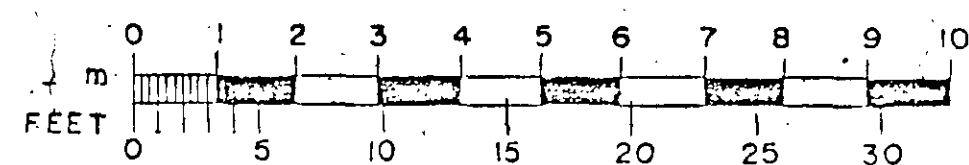

DATE	REVISIONS
MAR 31 1983	AS BUILT & METRIC CONVERSIONS

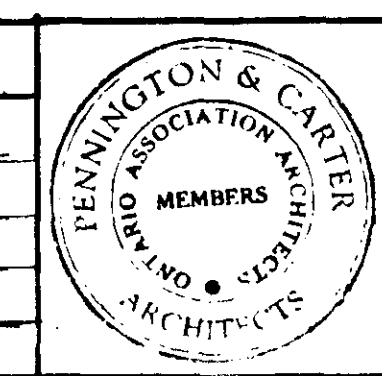

LIBRARY BUILDING
FOR
ASSUMPTION UNIVERSITY OF WINNIPEG

JOB NO.
1152